



# DRAWINGS FOR: CHATHAM VILLAGE CONDOMINIUM

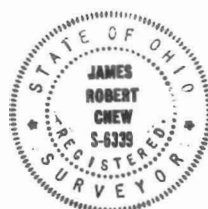

site plan

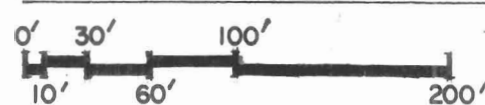

I DO HEREBY CERTIFY THAT THESE  
DRAWINGS DO ACCURATELY SHOW  
ALL BUILDINGS AS CONSTRUCTED

*James R. Chew*  
JAMES R. CHEW  
5/29/80 SURVEYOR



I DO HEREBY CERTIFY THAT  
THESE DRAWINGS DO ACCURATELY  
SHOW ALL BUILDINGS AS CONSTRUCTED

*Michael J. Fitzpatrick*  
MICHAEL J. FITZPATRICK  
OHIO 4588  
5/29/80 ARCHITECT

## unit index

bdg. no.	bdg. type	unit type	unit description	no. of units per bldg.	unit type	unit description	no. of units per bldg.	unit type	unit description	no. of units per bldg.	total no. of units
1	A	Ta	2 BR TH, 1-1/2 BATH W/ PATIO.....(4)	(4)	Tb	2 BR TH, 1-1/2 BATH W/ PATIO.....(8)	(8)	Fa	2 BR FLAT, 1 BATH W/ BALCONY.....(1)	(1)	13
2	B	Ta	2 BR TH, 1-1/2 BATH W/ PATIO.....(4)	(4)	Tb	2 BR TH, 1-1/2 BATH W/ PATIO.....(8)	(8)				12
3 8 13	C	Fc1	1 BR FLAT, 1 BATH W/ PATIO/BALCONY.....(12)	(12)							24
4 5	D	Ta	2 BR TH, 1-1/2 BATH W/ PATIO.....(6)	(6)							6
6 9	E	Ta	2 BR TH, 1-1/2 BATH W/ PATIO.....(8)	(8)	Tb	2 BR TH, 1-1/2 BATH W/ PATIO.....(4)	(4)	Fe	3 BR FLAT, 2 BATH W/ PATIO/BALCONY FIREPLACE.....(4)	(4)	16
7 10	F	Ta	2 BR TH, 1-1/2 BATH W/ PATIO.....(8)	(8)	Tb	2 BR TH, 1-1/2 BATH W/ PATIO.....(4)	(4)	Ff	3 BR FLAT, 2 BATH W/ PATIO/BALCONY FIREPLACE.....(4)	(4)	16
11 14	G	Fg	2 BR FLAT 1/2 BATH W/ PATIO/BALCONY.....(8)	(8)							8
12	H	Ta	2 BR TH, 1-1/2 BATH W/ PATIO.....(4)	(4)	Tb	2 BR TH, 1-1/2 BATH W/ PATIO.....(4)	(4)				8

TOTAL NUMBER OF UNITS.....197

## key to unit type designation

example: Ta INDICATES TOWNHOUSE UNIT


INDICATES TYPE (AND SIZE) OF TOWNHOUSE UNIT

example: Fc1 INDICATES FLAT UNIT  
(1) INDICATES FLOOR NO.  
INDICATES DIFFERENT UNITS PER BLDG (BLDG C ONLY)  
INDICATES BUILDING TYPE IN WHICH UNIT TYPE OCCURS

example: B FOR BLDG. TYPE C, E, G, F, THIS LETTER, APPEARING ON THE BLDG. PLAN, CORRESPONDS TO THE UNIT NUMBERS ON THE SITE PLAN. THE UNIT LETTERS ARE CONSISTENT FROM BUILDING TO BUILDING THEREFORE THE NUMBER PORTION OF THE UNIT NUMBER HAS BEEN OMITTED. IN THE CASE OF BLDG. TYPE C, THE FIRST LETTER REPRESENTS THE SECOND FLOOR, THE SECOND LETTER REPRESENTS THE THIRD FLOOR.

CHATHAM  
VILLAGE  
CONDOMINIUM

FITZPATRICK & ASSOCIATES  
ARCHITECTS, A.I.A.  
673 Mohawk St.  
Columbus, Ohio

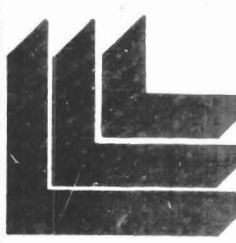

sheet title:

sheet number